



ASBUILT PLAN OF
APARTMENTS OF
11 YORKVILLE AVENUE
3rd FLOOR
 CITY OF TORONTO

NOT TO SCALE

WSP GEOMATICS ONTARIO LIMITED
 ONTARIO LAND SURVEYORS
 2017 © This plan is protected by copyright.

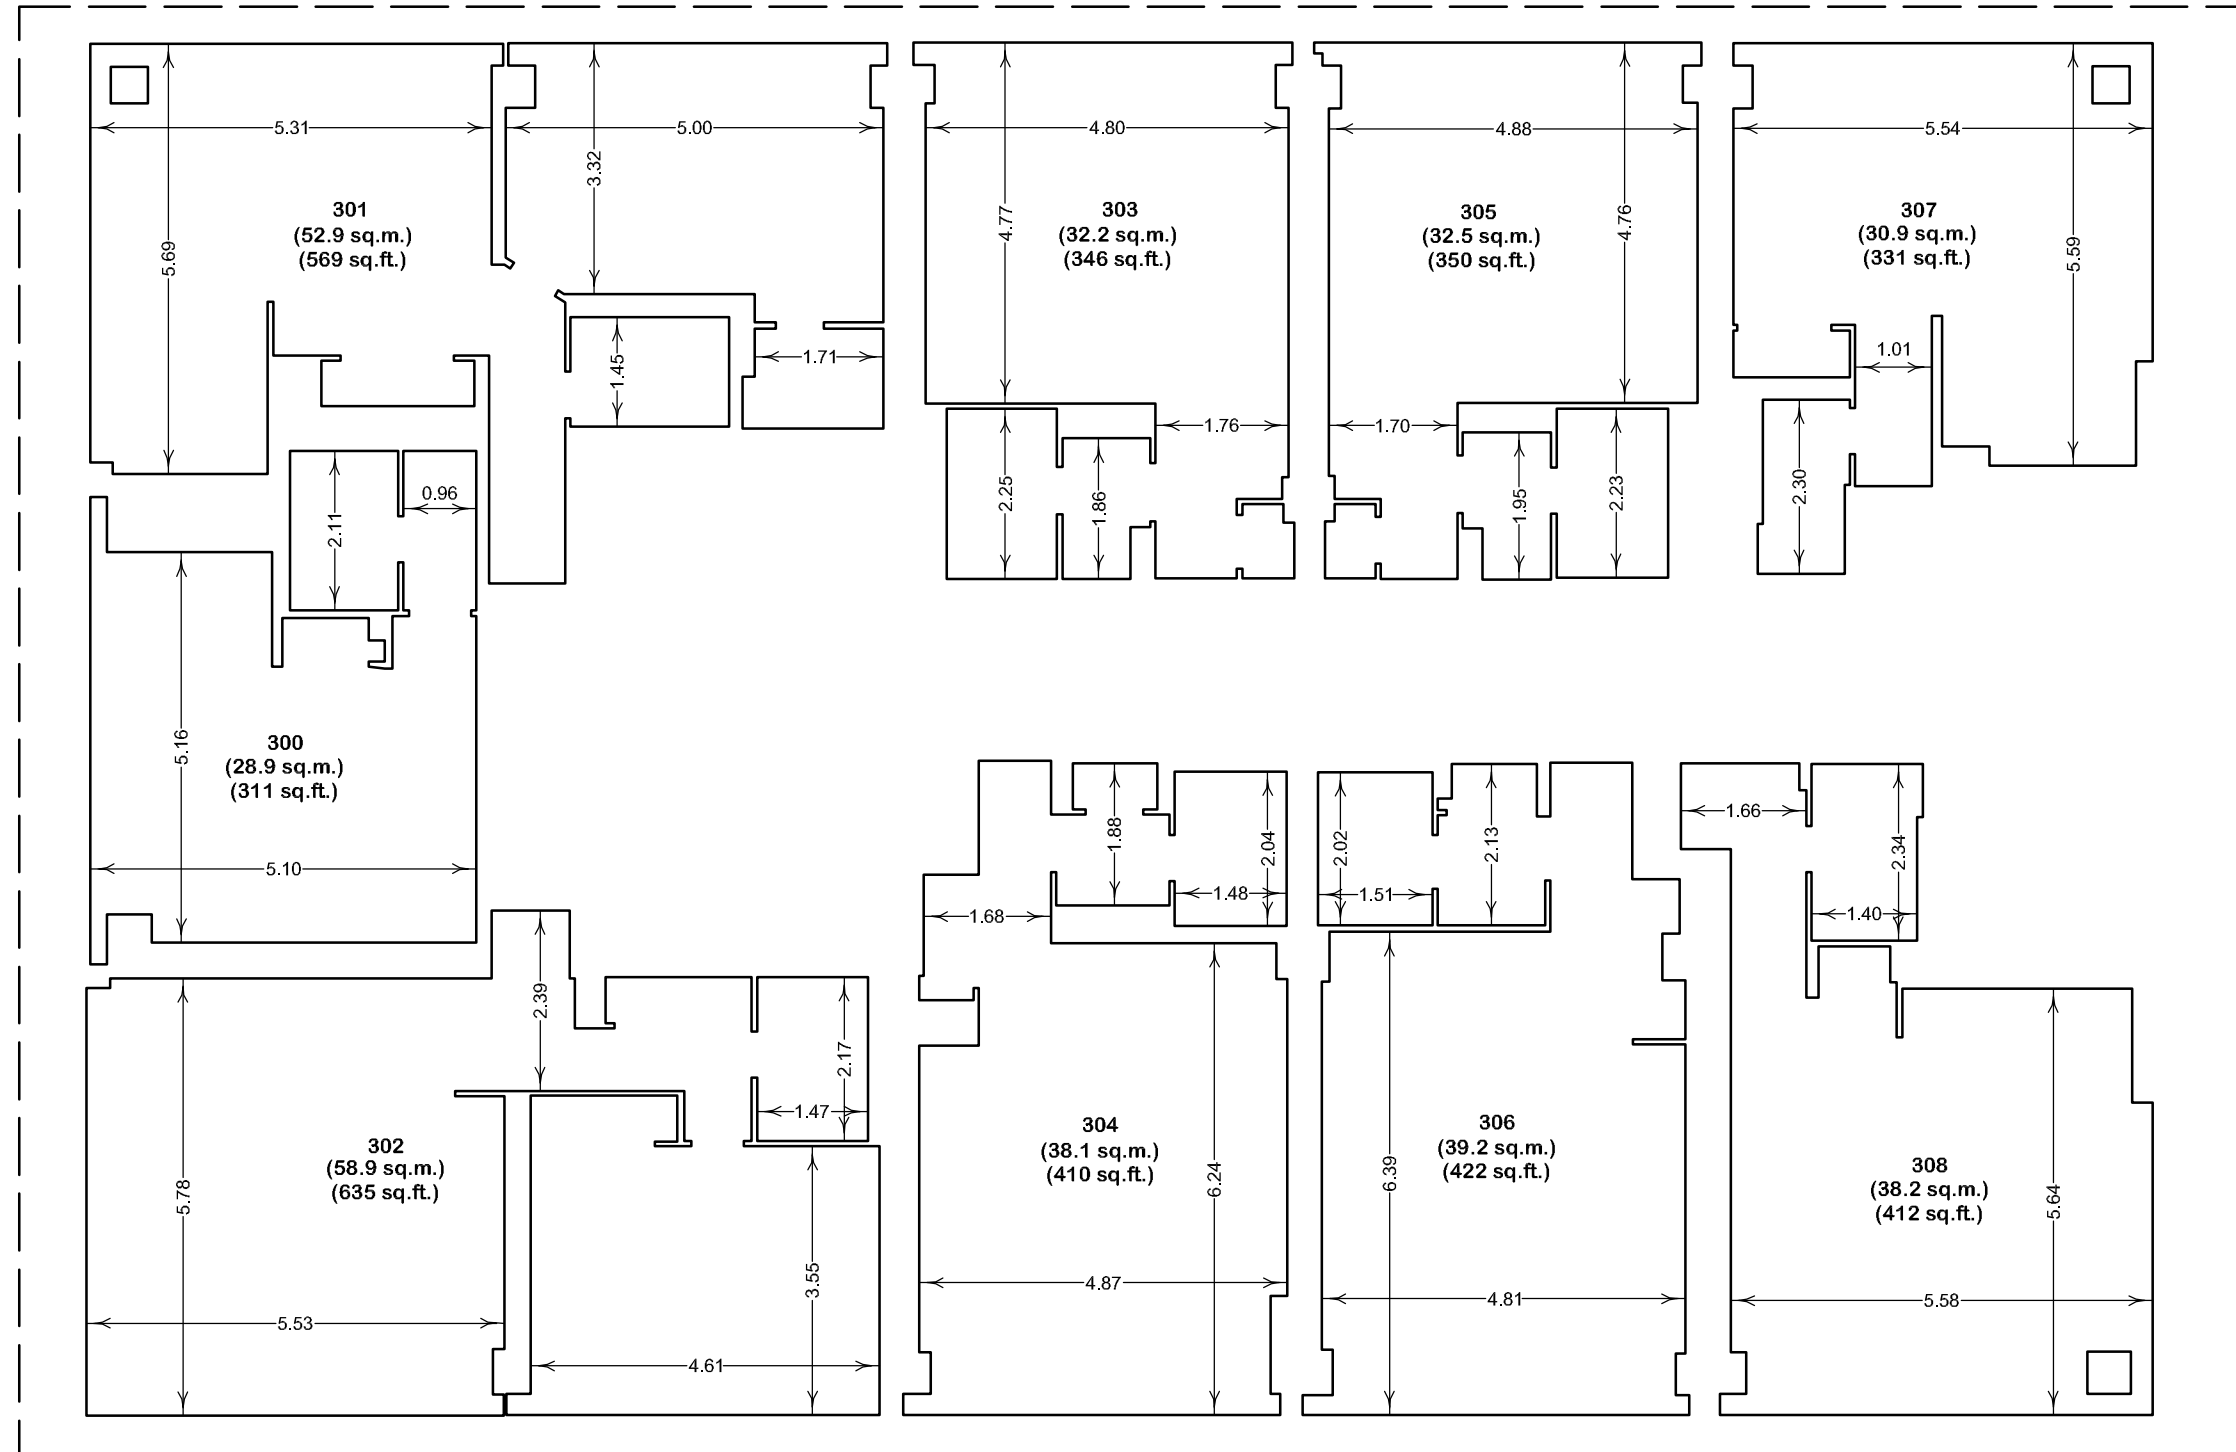



 WSP Geomatics Ontario Limited Ontario Land Surveyors	Drawing Number : 17M-01494-300	
	610 Chartwell Road, Suite 300, Oakville, Ontario Canada, L6J 4A5 t: 905-823-8500 f: 905-823-8503 Website : www.wspgroup.ca	
P.Chief : A.K.	Dwg. By : C.E.W.	Chk'd by : G.M.
Job Number : 17M-01494-00-AV1	Tab Name: 300	
Dwg File Name:	11 YORKVILLE.DWG	

ASBUILT PLAN OF
APARTMENTS OF
11 YORKVILLE AVENUE
4th FLOOR
 CITY OF TORONTO

NOT TO SCALE

WSP GEOMATICS ONTARIO LIMITED
 ONTARIO LAND SURVEYORS
 2017 © This plan is protected by copyright.

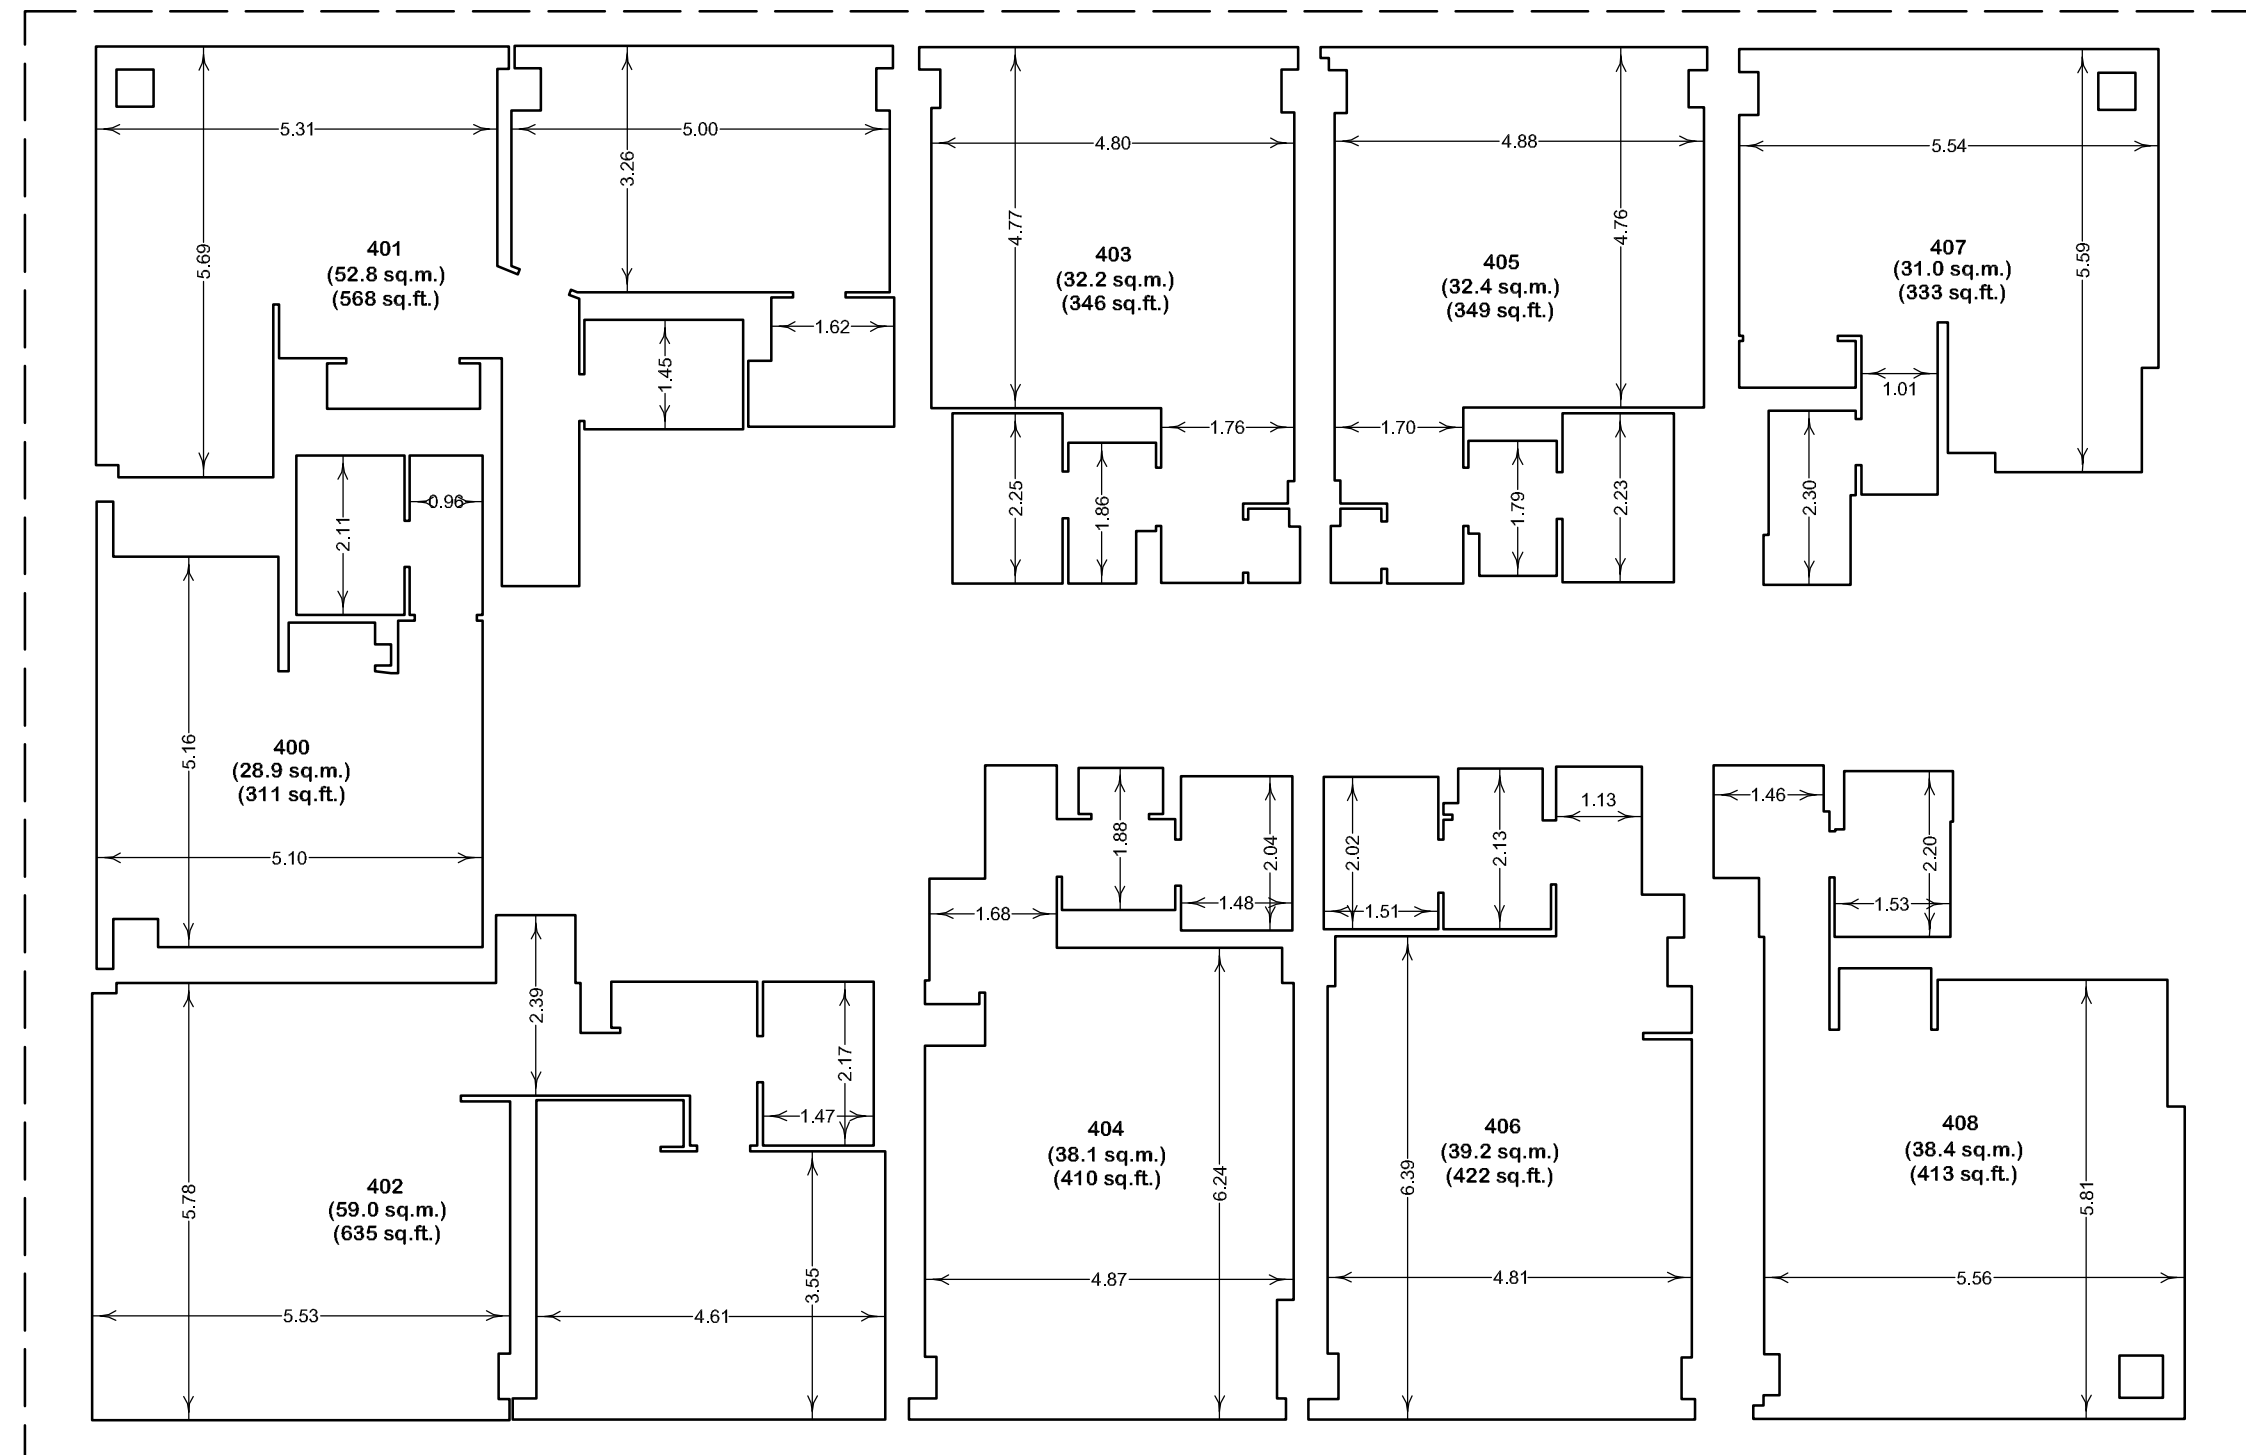



 WSP Geomatics Ontario Limited Ontario Land Surveyors	Drawing Number : 17M-01494-400	
	610 Chartwell Road, Suite 300, Oakville, Ontario Canada, L6J 4A5 t: 905-823-8500 f: 905-823-8503 Website : www.wspgroup.ca	
P.Chief : A.K.	Dwg. By : C.E.W.	Chk'd by : G.M.
Job Number : 17M-01494-00-AV1		Tab Name: 400
Dwg File Name:		11 YORKVILLE.DWG

ASBUILT PLAN OF
APARTMENTS OF
11 YORKVILLE AVENUE
5th FLOOR
 CITY OF TORONTO

NOT TO SCALE

WSP GEOMATICS ONTARIO LIMITED
 ONTARIO LAND SURVEYORS
 2017 © This plan is protected by copyright.

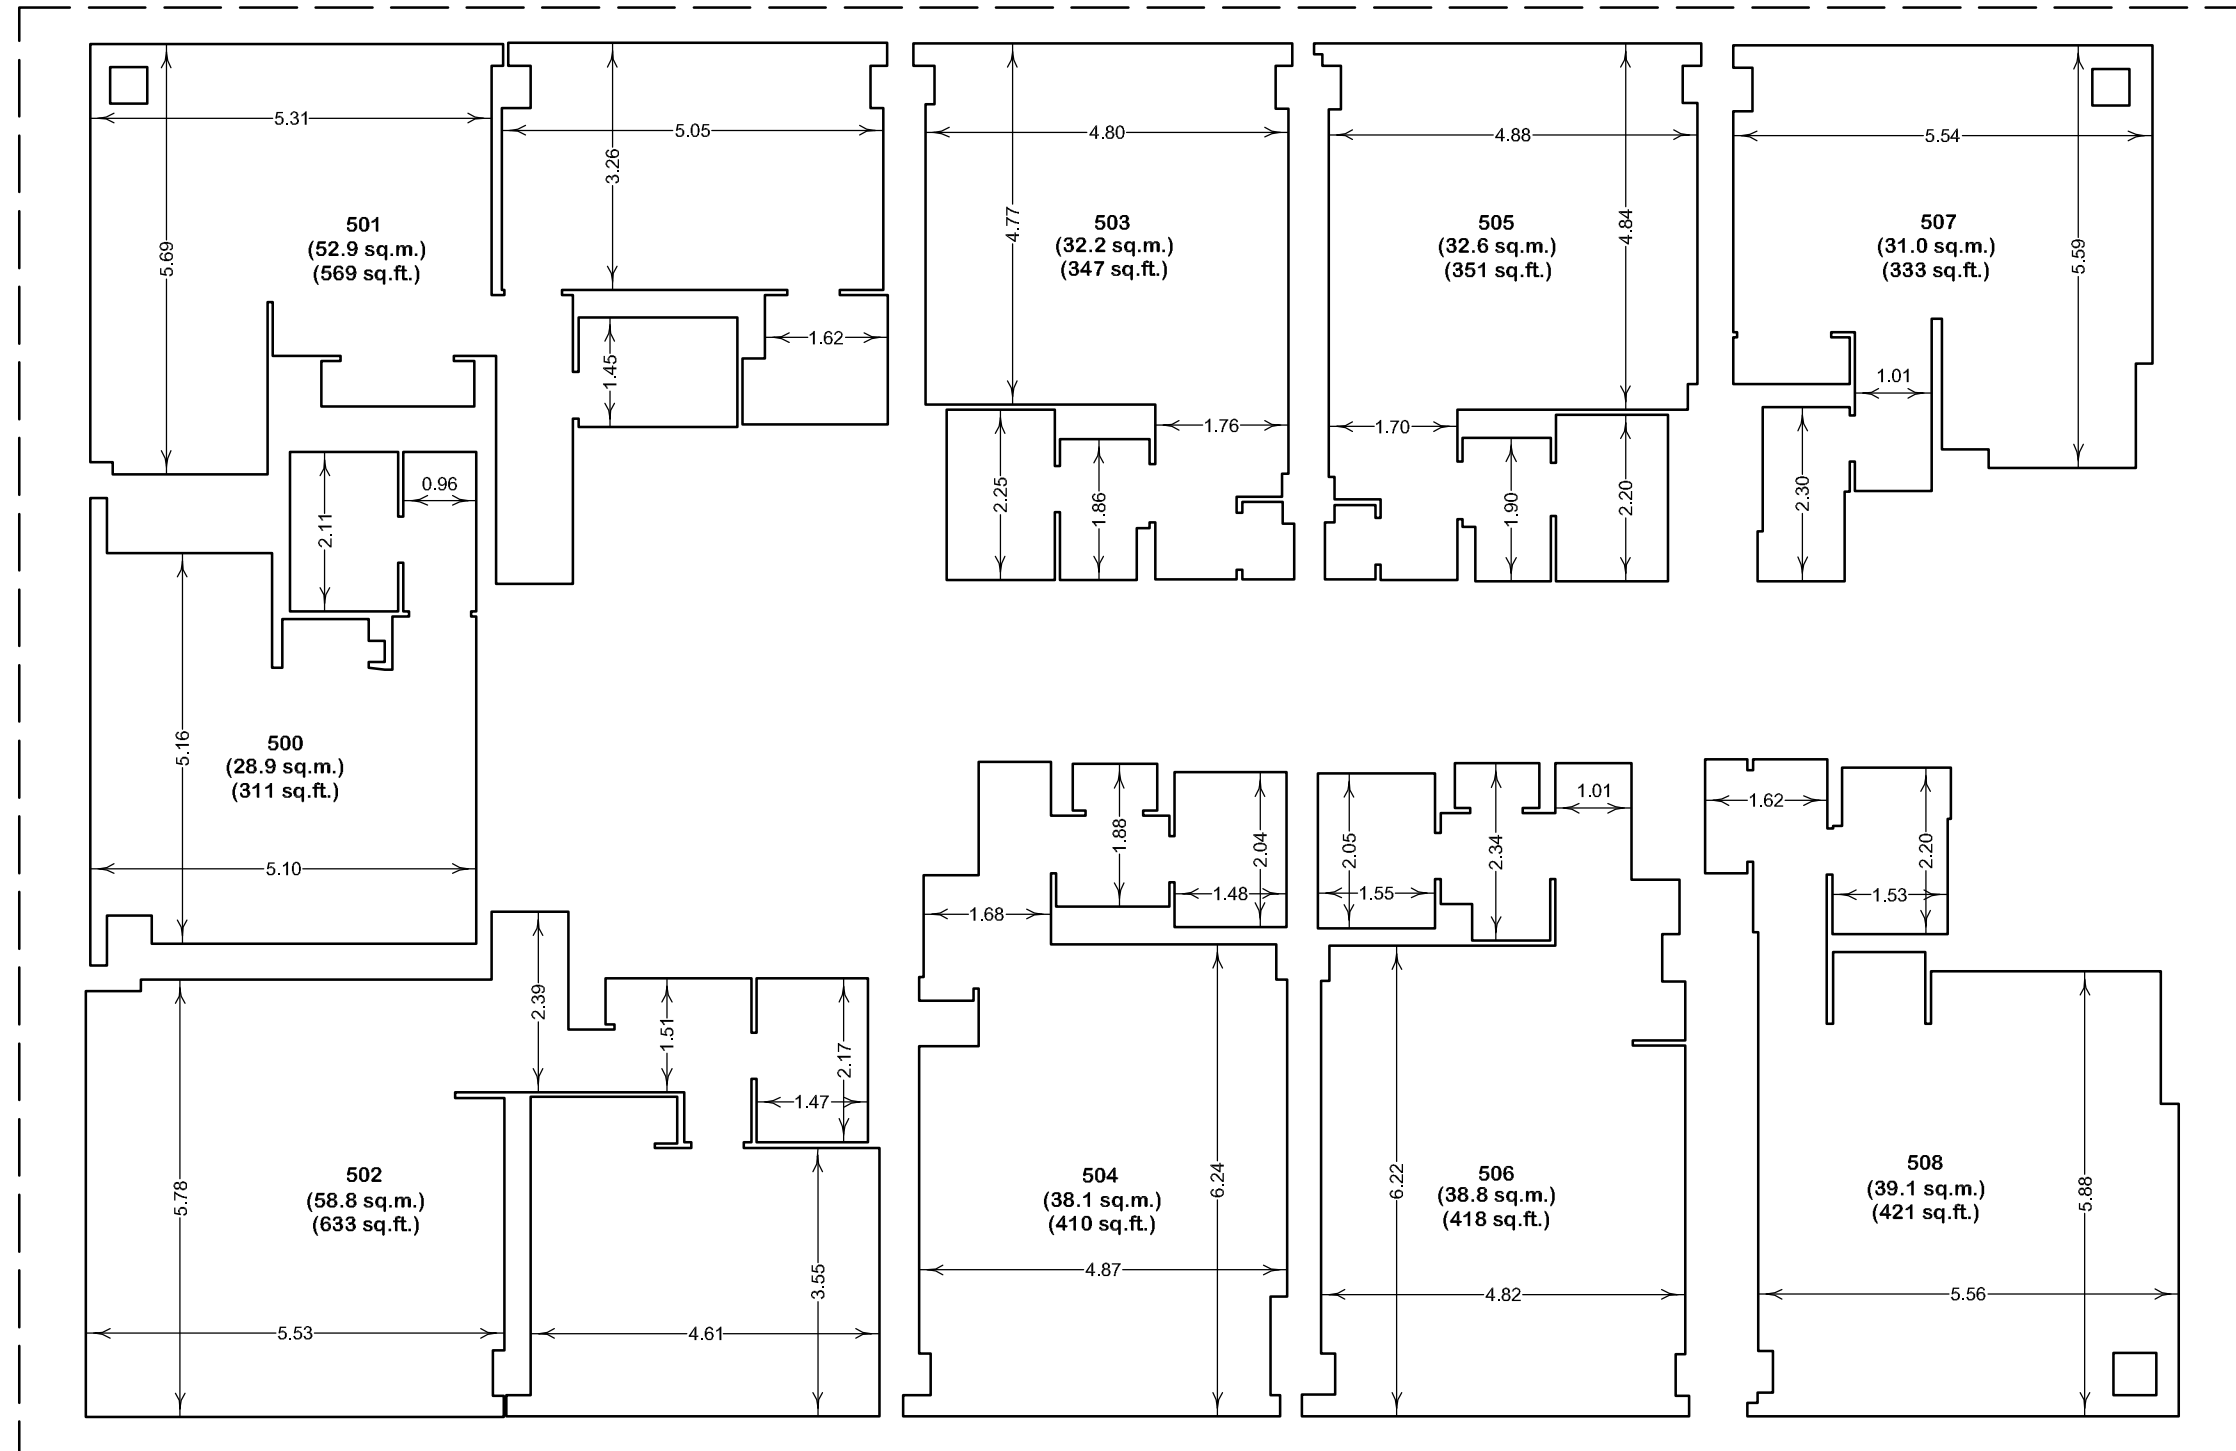


 WSP Geomatics Ontario Limited Ontario Land Surveyors	Drawing Number : 17M-01494-500	
	610 Chartwell Road, Suite 300, Oakville, Ontario Canada, L6J 4A5 t: 905-823-8500 f: 905-823-8503 Website : www.wspgroup.ca	
P.Chief : A.K.	Dwg. By : C.E.W.	Chk'd by : G.M.
Job Number : 17M-01494-00-AV1	Tab Name: 500	
Dwg File Name:	11 YORKVILLE.DWG	


K:\Jobs\1717M-01494 Yorkville\dwg\11 Yorkville.dwg

ASBUILT PLAN OF
APARTMENTS OF
11 YORKVILLE AVENUE
6th FLOOR
 CITY OF TORONTO

NOT TO SCALE

WSP GEOMATICS ONTARIO LIMITED
 ONTARIO LAND SURVEYORS
 2017 © This plan is protected by copyright.

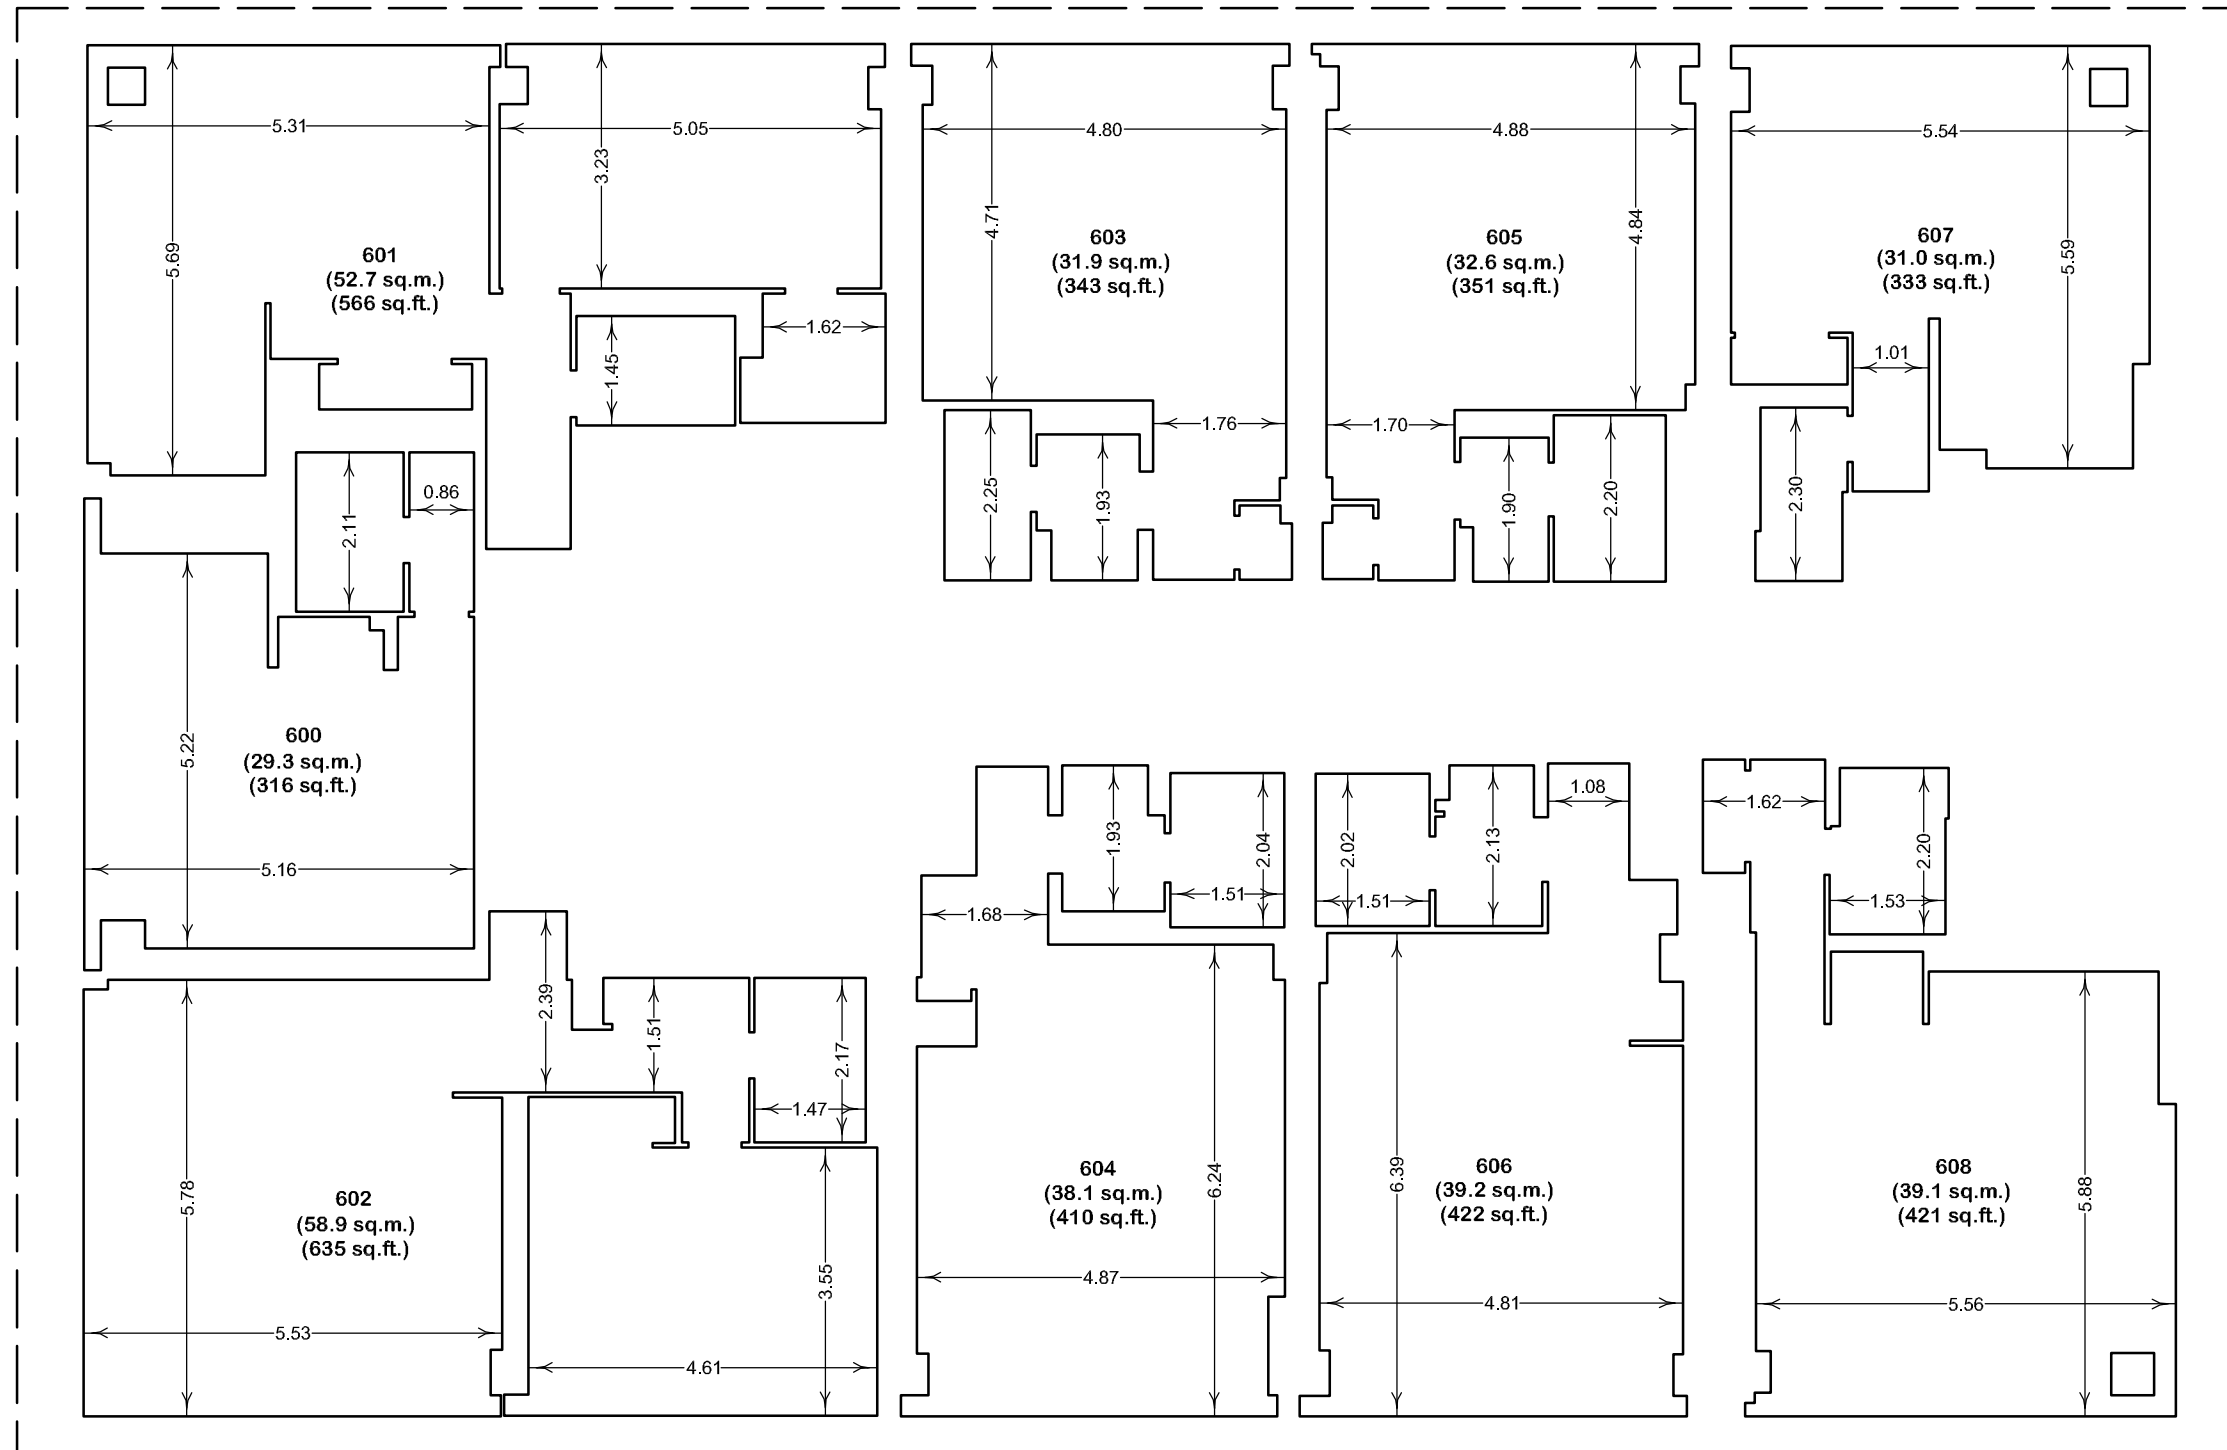


 WSP Geomatics Ontario Limited Ontario Land Surveyors	Drawing Number : 17M-01494-600	
	610 Chartwell Road, Suite 300, Oakville, Ontario Canada, L6J 4A5 t: 905-823-8500 f: 905-823-8503 Website : www.wspgroup.ca	
P.Chief : A.K.	Dwg. By : C.E.W.	Chk'd by : G.M.
Job Number : 17M-01494-00-AV1	Tab Name: 600	
Dwg File Name:	11 YORKVILLE.DWG	


K:\Jobs\17\17M-01494 Yorkville.dwg\11 Yorkville.dwg

ASBUILT PLAN OF
APARTMENTS OF
11 YORKVILLE AVENUE
7th FLOOR
 CITY OF TORONTO

NOT TO SCALE

WSP GEOMATICS ONTARIO LIMITED
 ONTARIO LAND SURVEYORS
 2017 © This plan is protected by copyright.

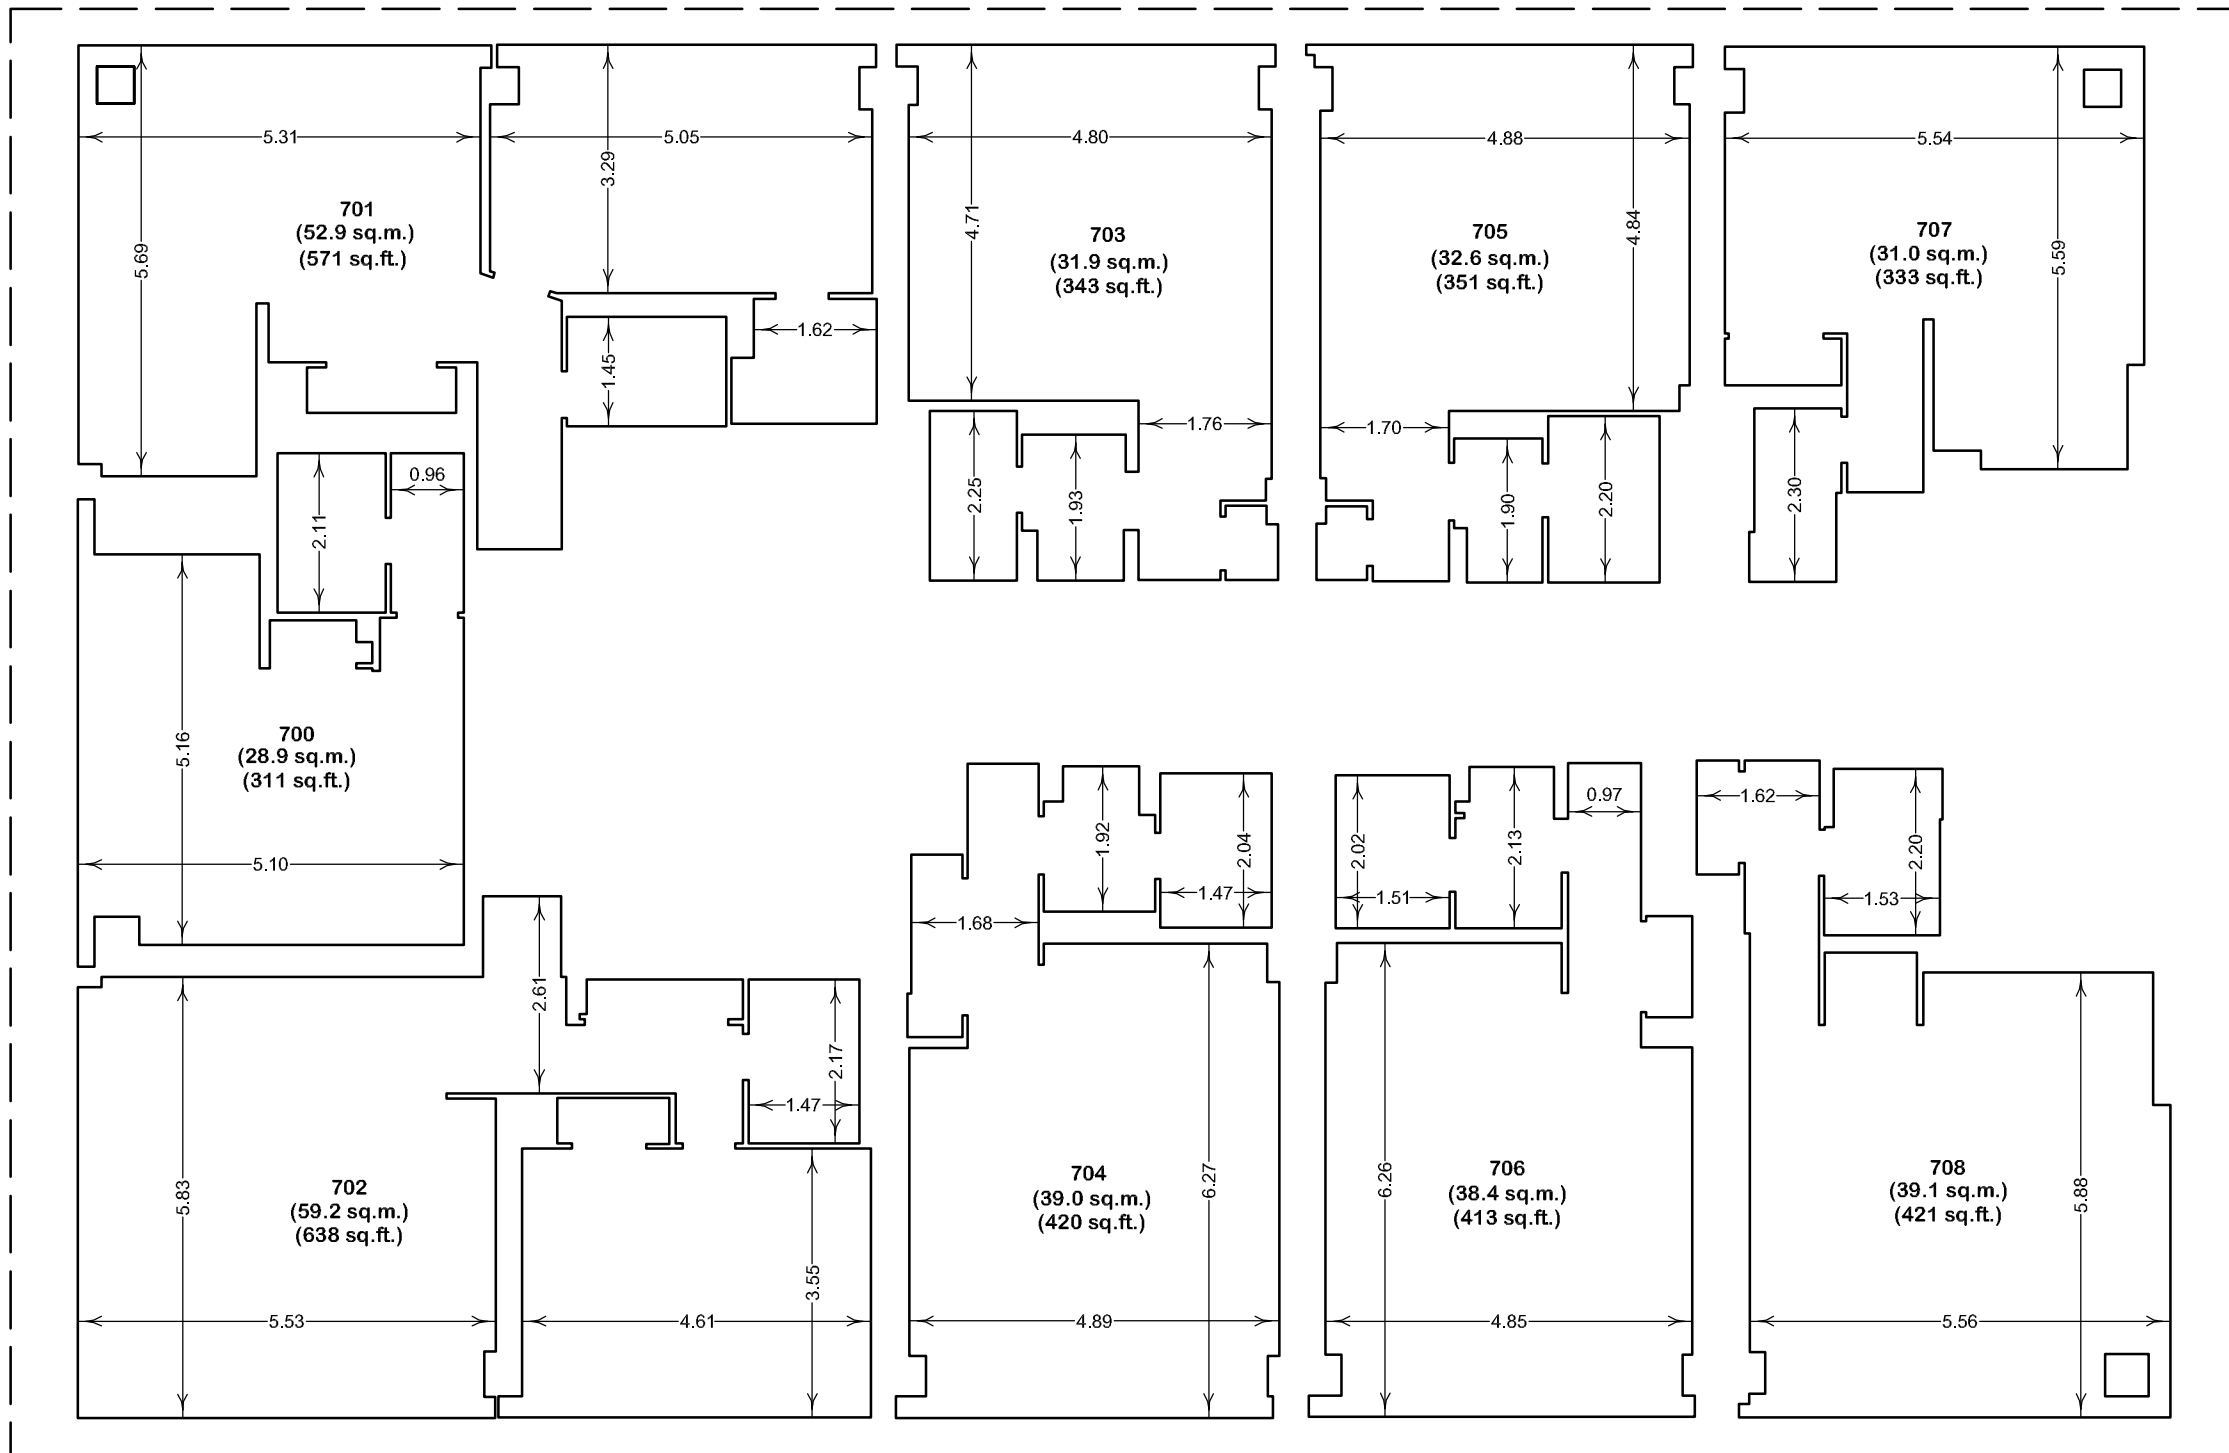


 WSP Geomatics Ontario Limited Ontario Land Surveyors	Drawing Number : 17M-01494-700	
	610 Chartwell Road, Suite 300, Oakville, Ontario Canada, L6J 4A5 t: 905-823-8500 f: 905-823-8503 Website : www.wspgroup.ca	
P.Chief : A.K.	Dwg. By : C.E.W.	Chk'd by : G.M.
Job Number : 17M-01494-00-AV1	Tab Name: 700	
Dwg File Name:		11 YORKVILLE.DWG


K:\Jobs\1717M-01494 Yorkville.dwg\11 Yorkville.dwg

ASBUILT PLAN OF
APARTMENTS OF
11 YORKVILLE AVENUE
8th FLOOR
 CITY OF TORONTO

NOT TO SCALE

WSP GEOMATICS ONTARIO LIMITED
 ONTARIO LAND SURVEYORS
 2017 © This plan is protected by copyright.

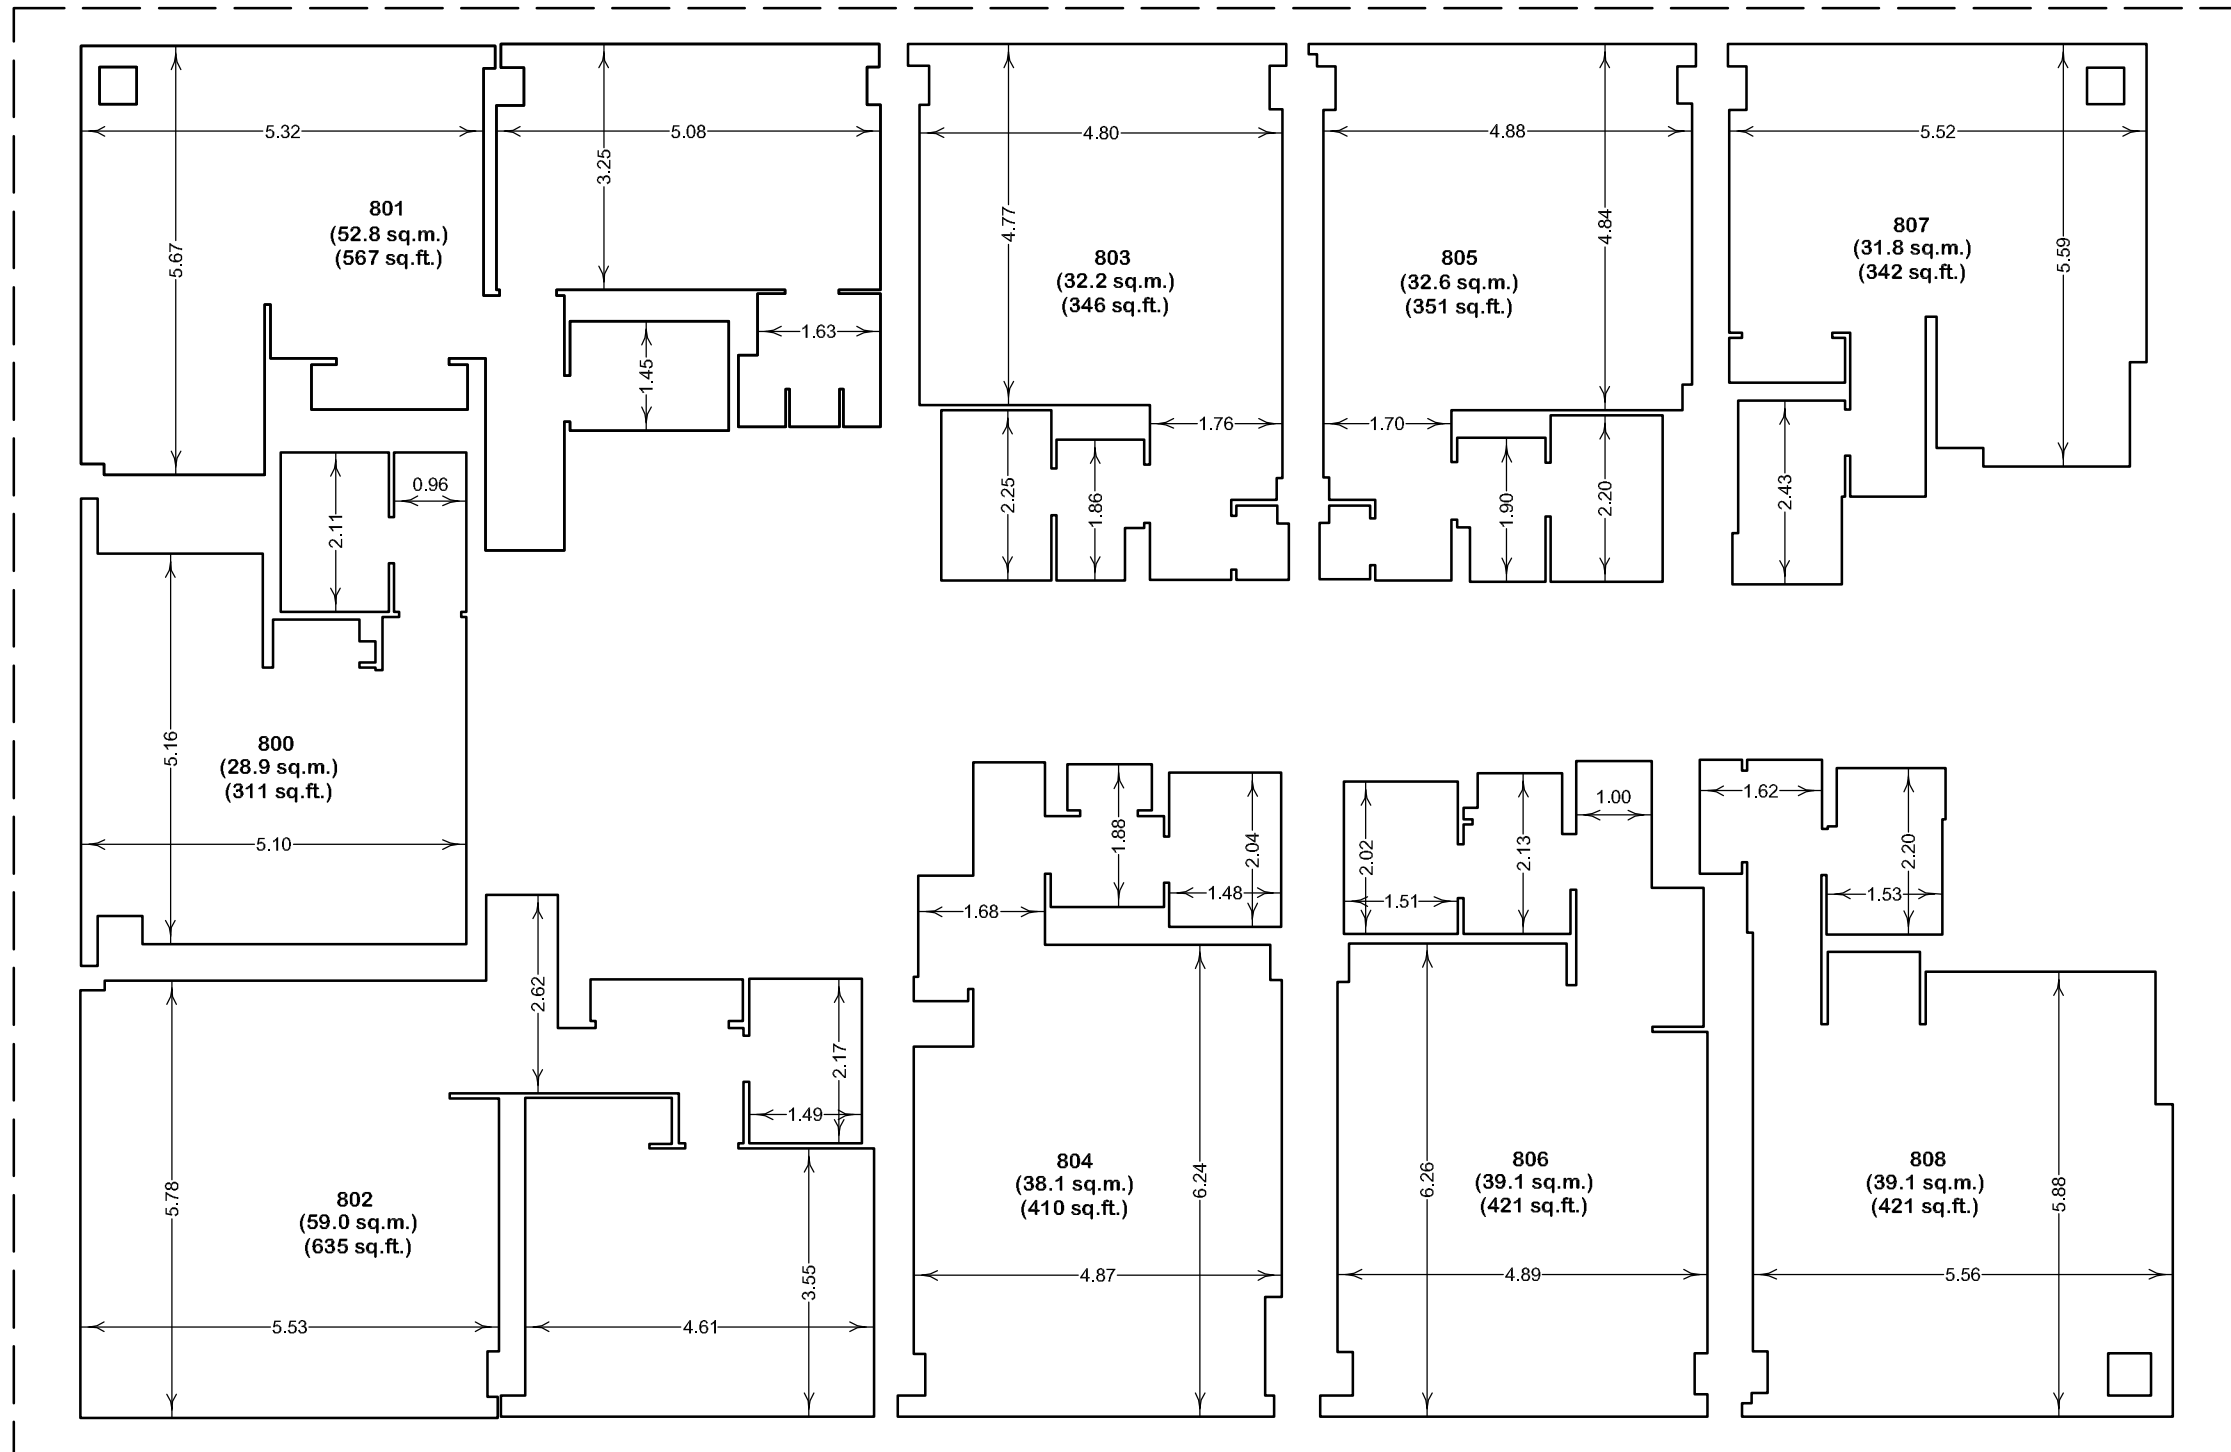



 WSP Geomatics Ontario Limited Ontario Land Surveyors	Drawing Number : 17M-01494-800	
	610 Chartwell Road, Suite 300, Oakville, Ontario Canada, L6J 4A5 t: 905-823-8500 f: 905-823-8503 Website : www.wspgroup.ca	
P.Chief : A.K.	Dwg. By : C.E.W.	Chk'd by : G.M.
Job Number : 17M-01494-00-AV1		Tab Name: 800
Dwg File Name:		11 YORKVILLE.DWG

ASBUILT PLAN OF
APARTMENTS OF
11 YORKVILLE AVENUE
9th FLOOR
 CITY OF TORONTO

NOT TO SCALE

WSP GEOMATICS ONTARIO LIMITED
 ONTARIO LAND SURVEYORS
 2017 © This plan is protected by copyright.

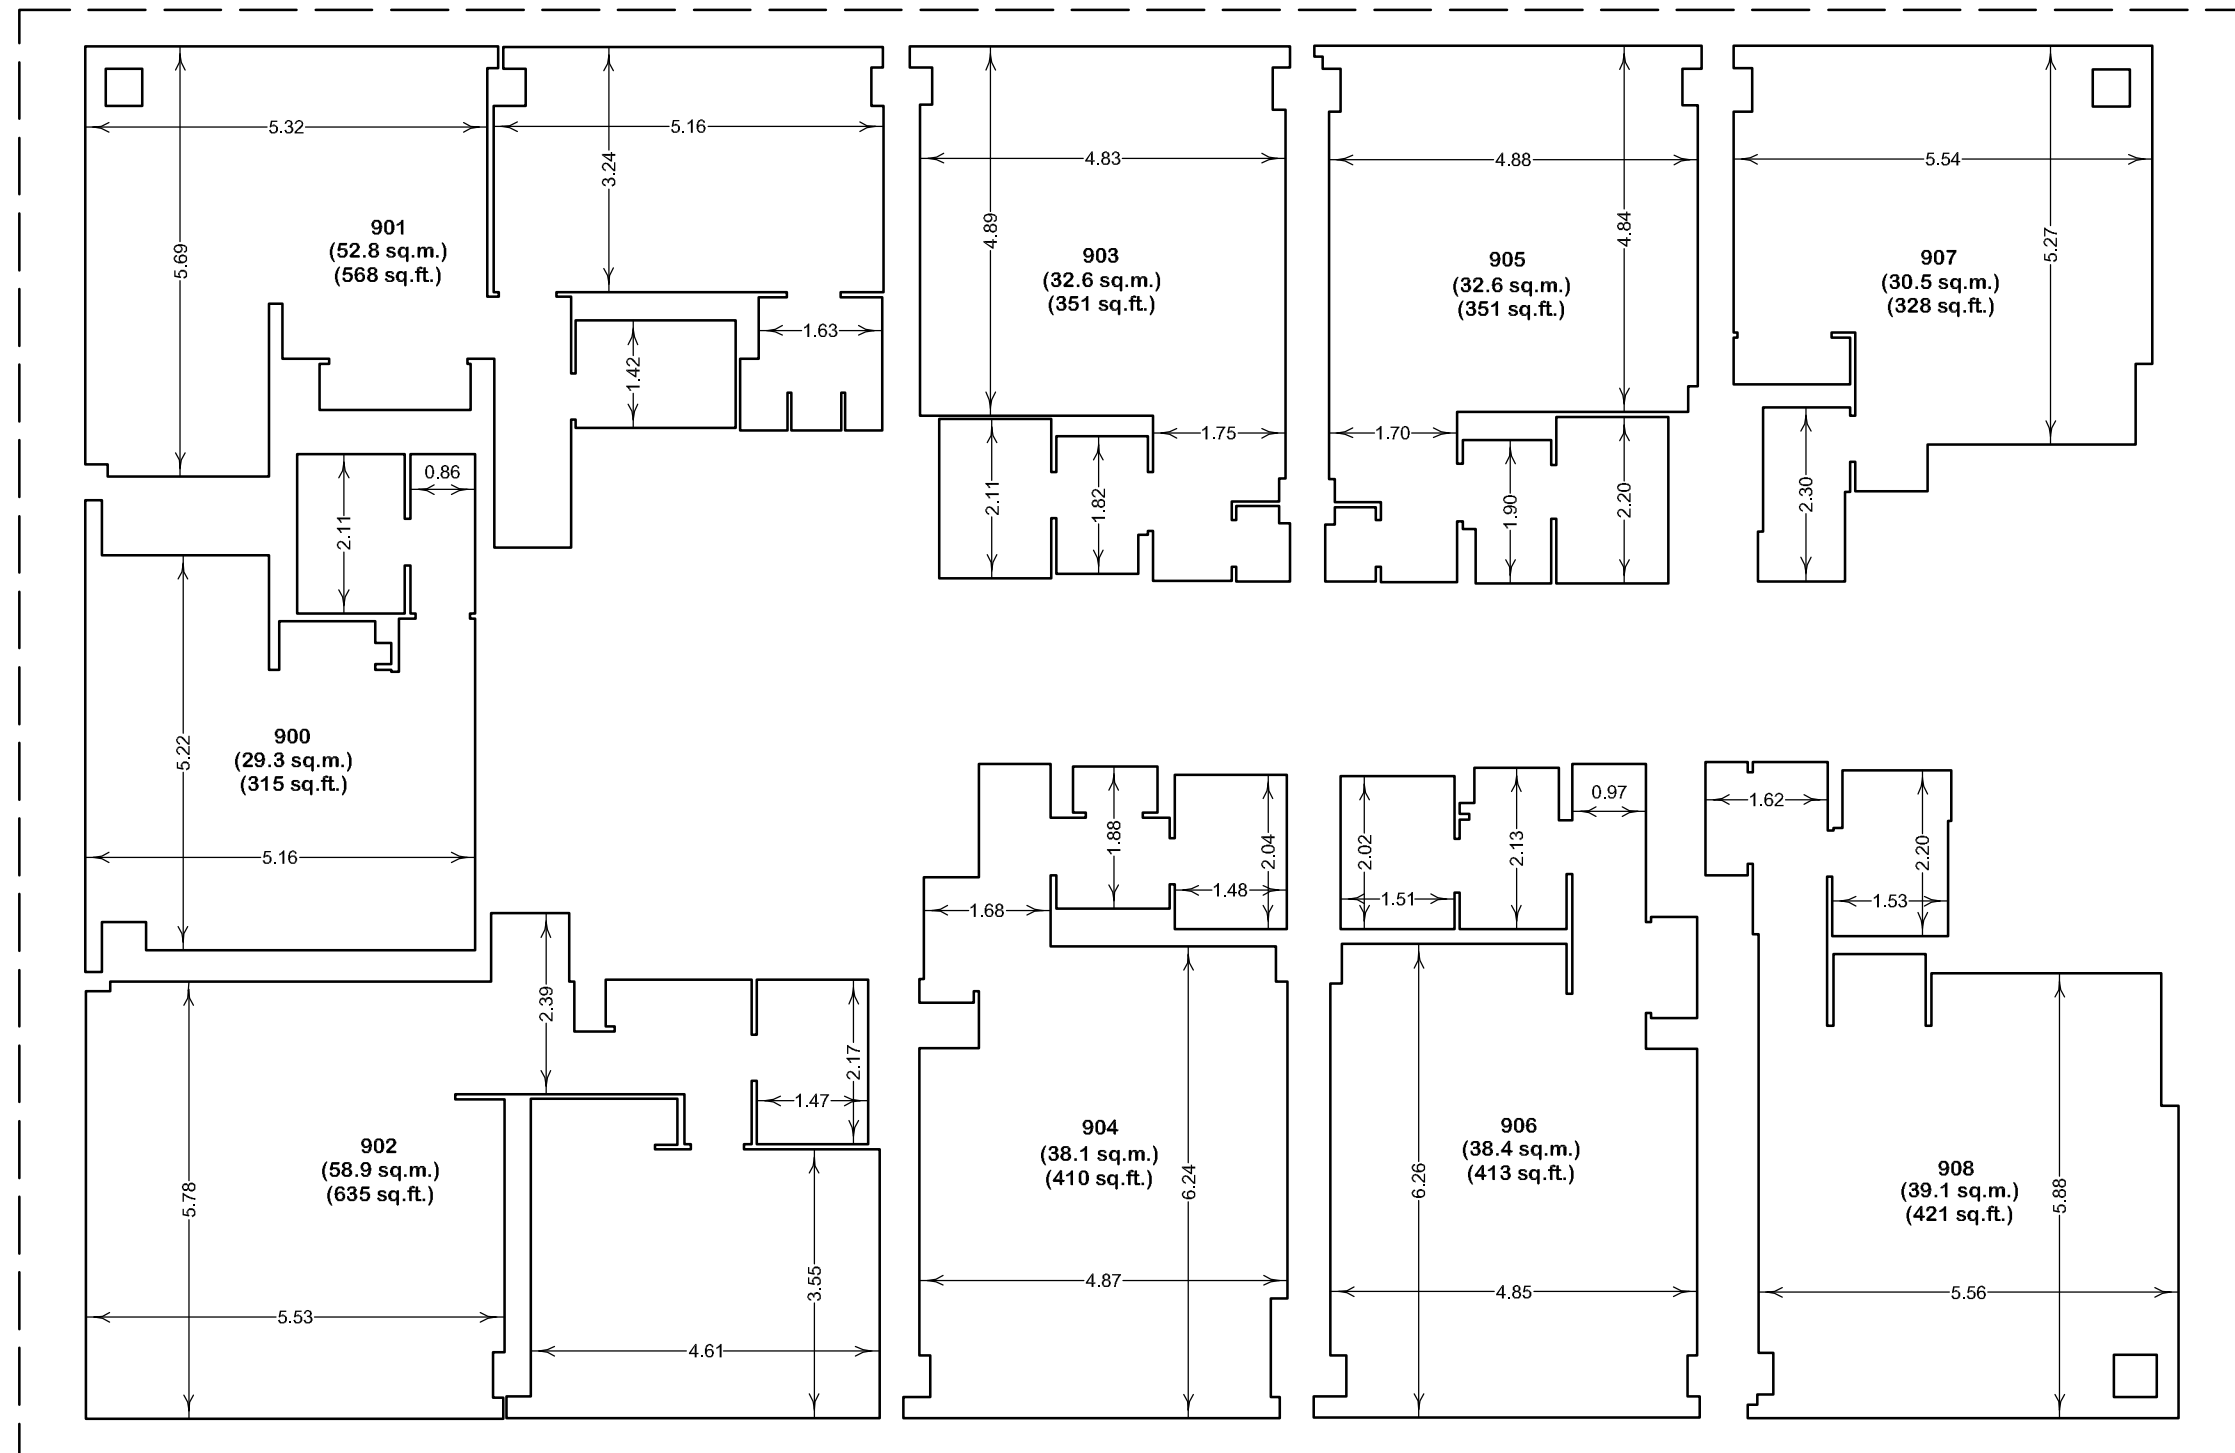



 WSP Geomatics Ontario Limited Ontario Land Surveyors	Drawing Number : 17M-01494-900	
	610 Chartwell Road, Suite 300, Oakville, Ontario Canada, L6J 4A5 t: 905-823-8500 f: 905-823-8503 Website : www.wspgroup.ca	
P.Chief : A.K.	Dwg. By : C.E.W.	Chk'd by : G.M.
Job Number : 17M-01494-00-AV1	Tab Name: 900	
Dwg File Name:		11 YORKVILLE.DWG

ASBUILT PLAN OF
APARTMENTS OF
11 YORKVILLE AVENUE
10th FLOOR
 CITY OF TORONTO

NOT TO SCALE

WSP GEOMATICS ONTARIO LIMITED
 ONTARIO LAND SURVEYORS
 2017 © This plan is protected by copyright.

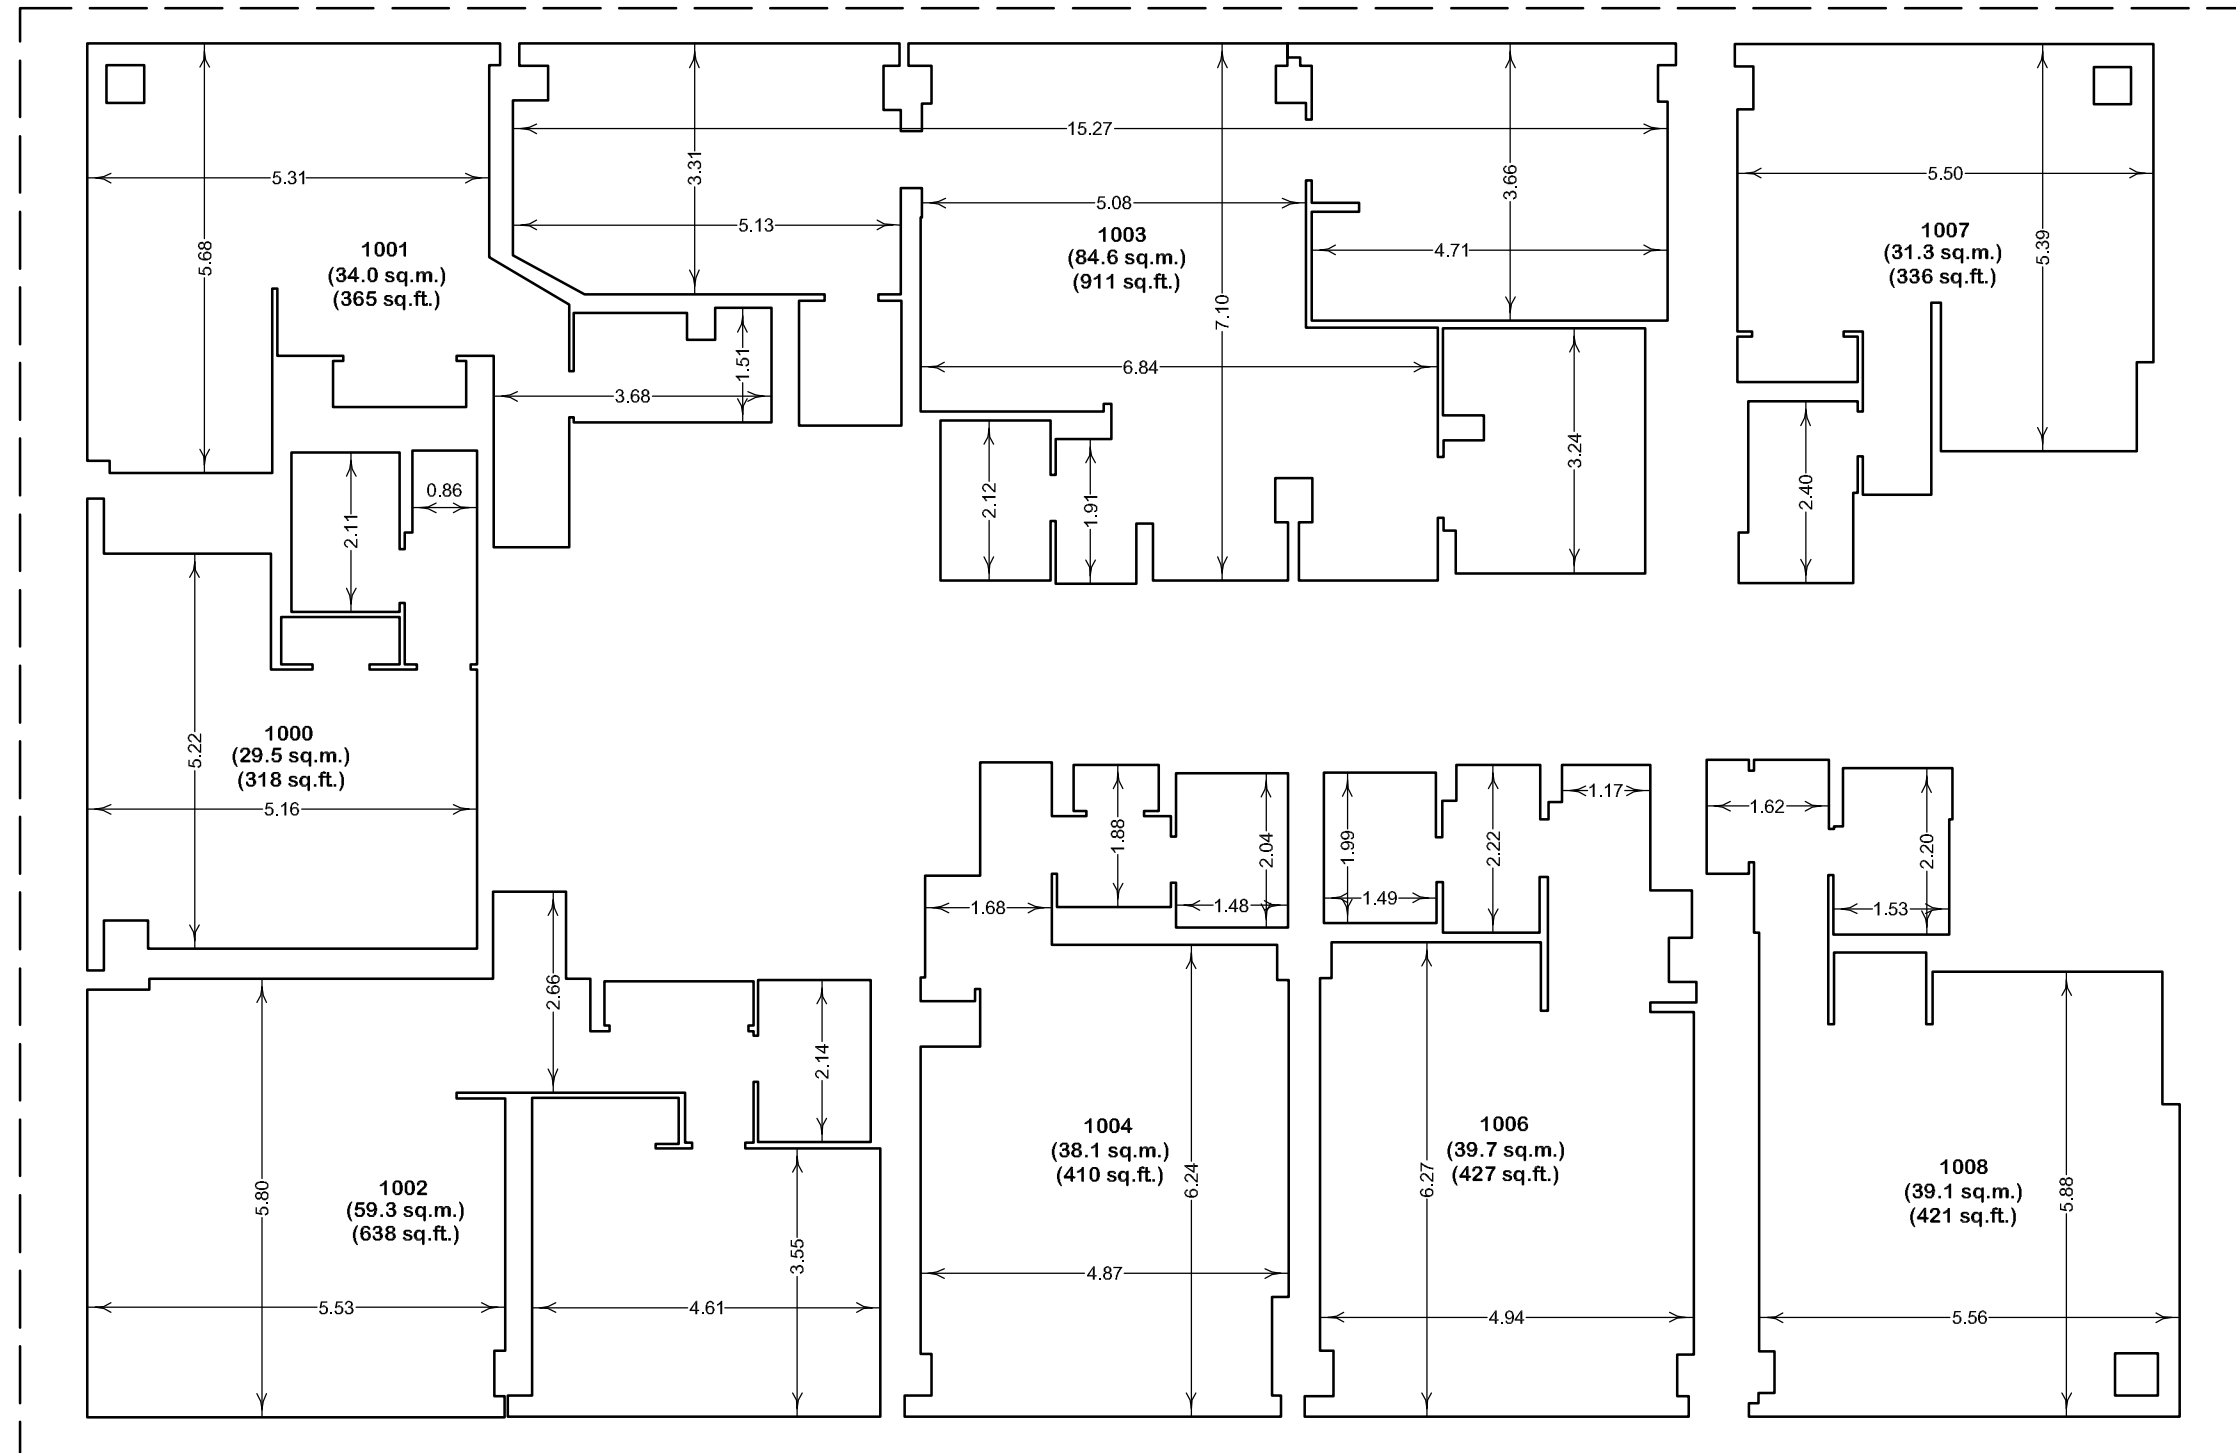

 WSP Geomatics Ontario Limited Ontario Land Surveyors	Drawing Number : 17M-01494-1000	
	610 Chartwell Road, Suite 300, Oakville, Ontario Canada, L6J 4A5 t: 905-823-8500 f: 905-823-8503 Website : www.wspgroup.ca	
P.Chief : A.K.	Dwg. By : C.E.W.	Chk'd by : G.M.
Job Number : 17M-01494-00-AV1	Tab Name: 1000	
Dwg File Name:	11 YORKVILLE.DWG	

K:\jobs\17\17M-01494-Yorkville\dwg\11 Yorkville.dwg