




ASBUILT PLAN OF  
**APARTMENTS OF**  
**19 YORKVILLE AVENUE**  
 CITY OF TORONTO

NOT TO SCALE  
**WSP GEOMATICS ONTARIO LIMITED**  
 ONTARIO LAND SURVEYORS  
 2018 © This plan is protected by copyright.

TOTAL AREA:

APARTMENT 1 = 92.4 SQ.M.

APARTMENT 2 = 169.4 SQ.M.

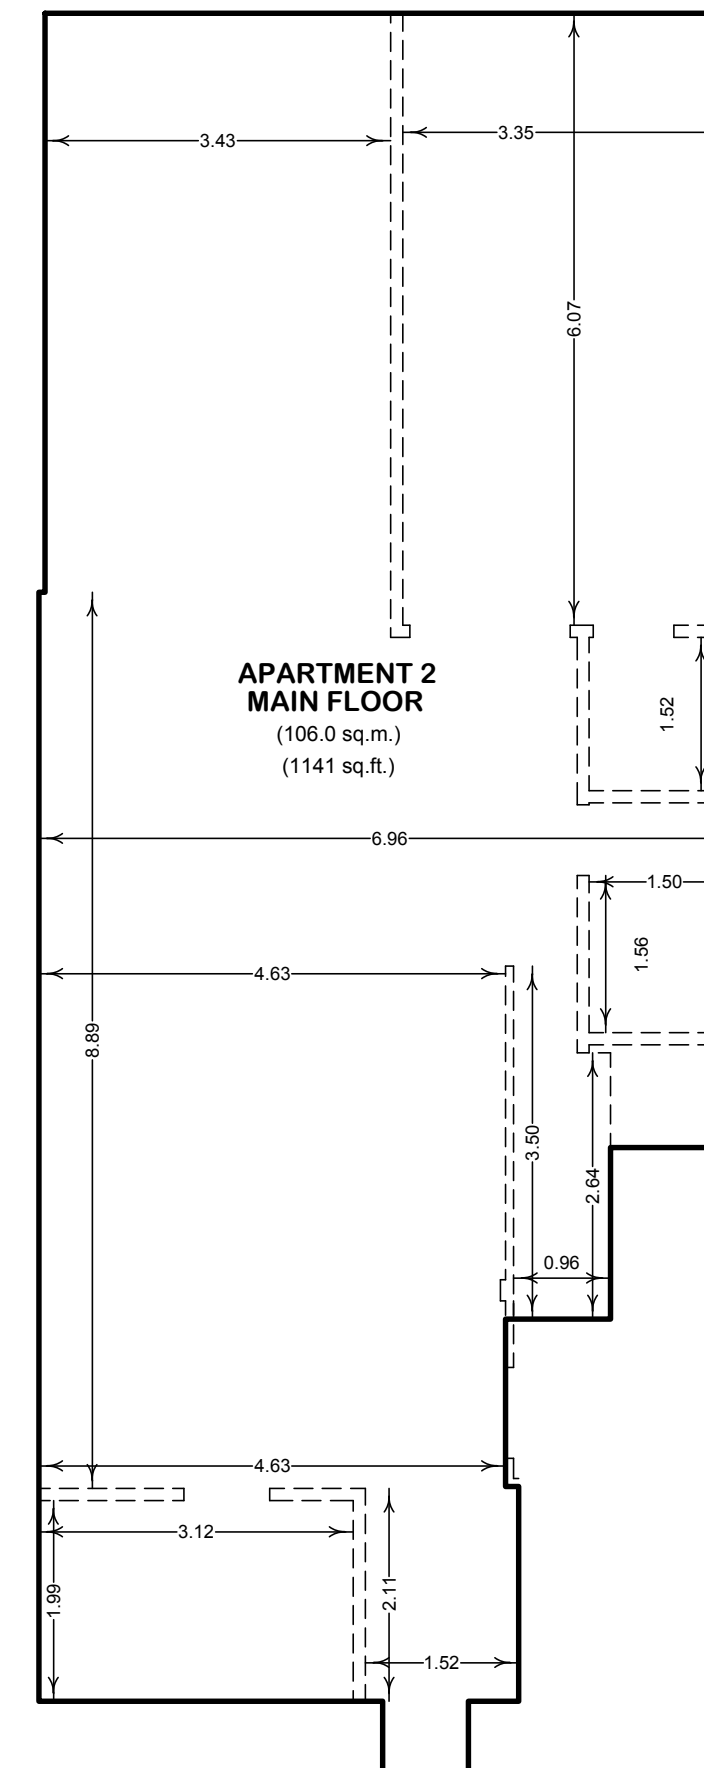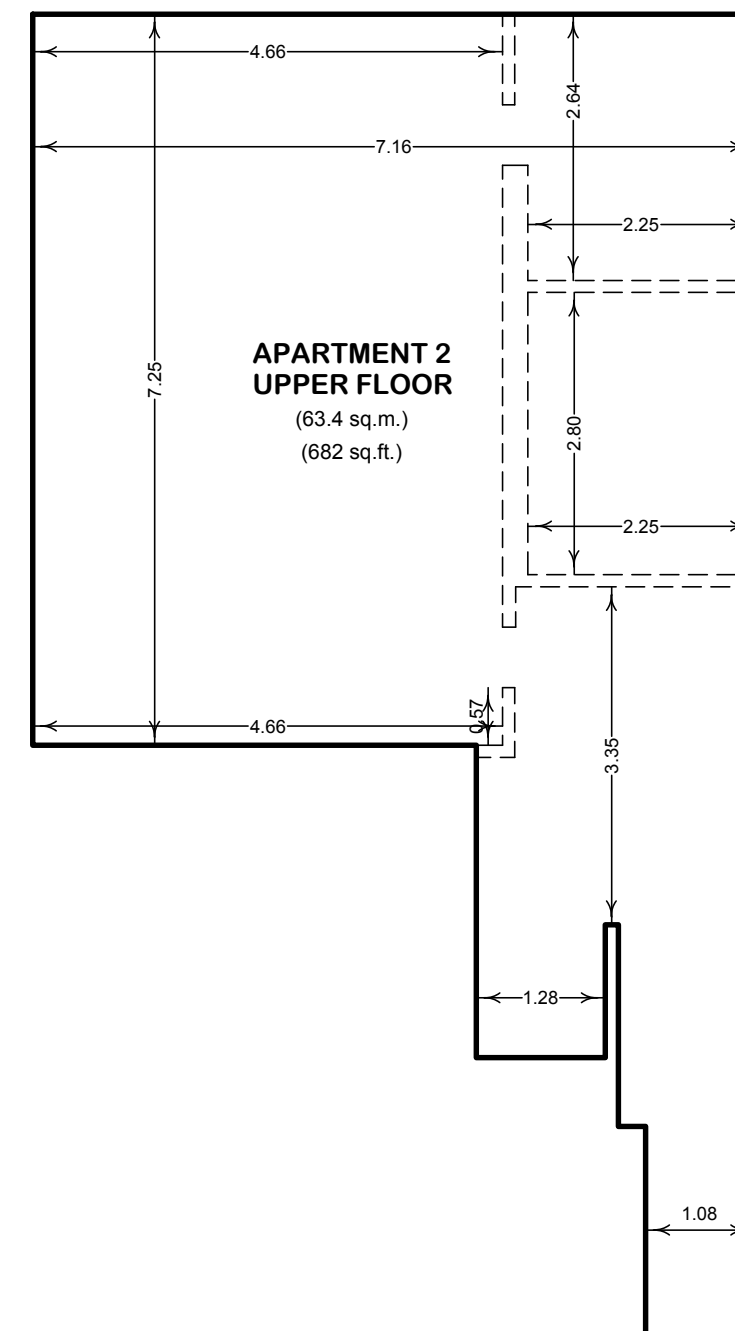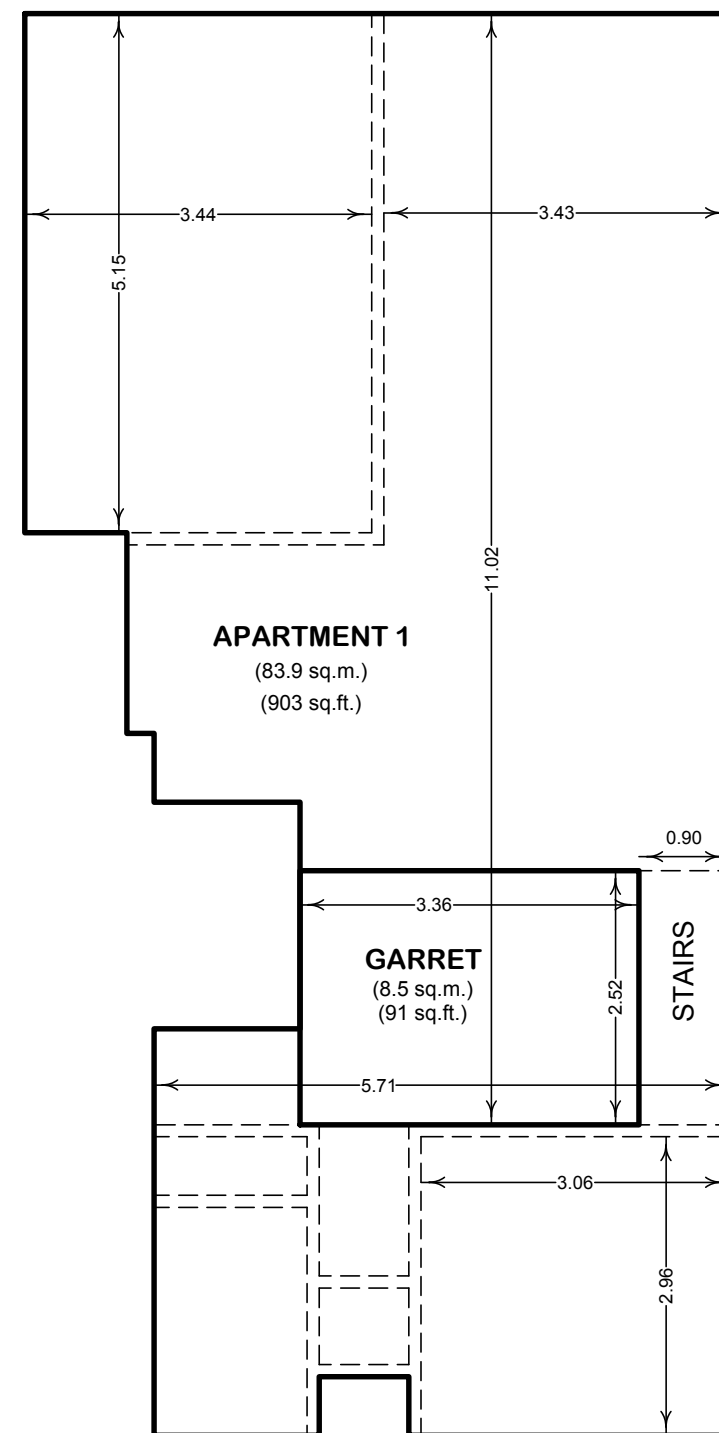

|                               |  |  |
|-------------------------------|--|--|
|                               | WSP Geomatics Ontario Limited<br>Ontario Land Surveyors  | Drawing Number :<br><b>17M-01494-019</b> |
|                               | 610 Chartwell Road, Suite 300, Oakville, Ontario Canada, L6J 4A5<br>t: 905-823-8500 f: 905-823-8503<br>Website : www.wspgroup.ca |  |
| P.Chief : A.K.                | Dwg. By : C.E.W.   | Chk'd by : G.M.                          |
| Job Number : 17M-01494-00-AV1 | Tab Name: APT 1-3  |  |
| Dwg File Name:                | 19 YORKVILLE.DWG   |  |

K:\Jobs\171717M-01494-Yorkville.dwg 19 Yorkville.dwg