


ASBUILT PLAN OF  
 APARTMENTS OF  
 21 YORKVILLE AVENUE  
 CITY OF TORONTO

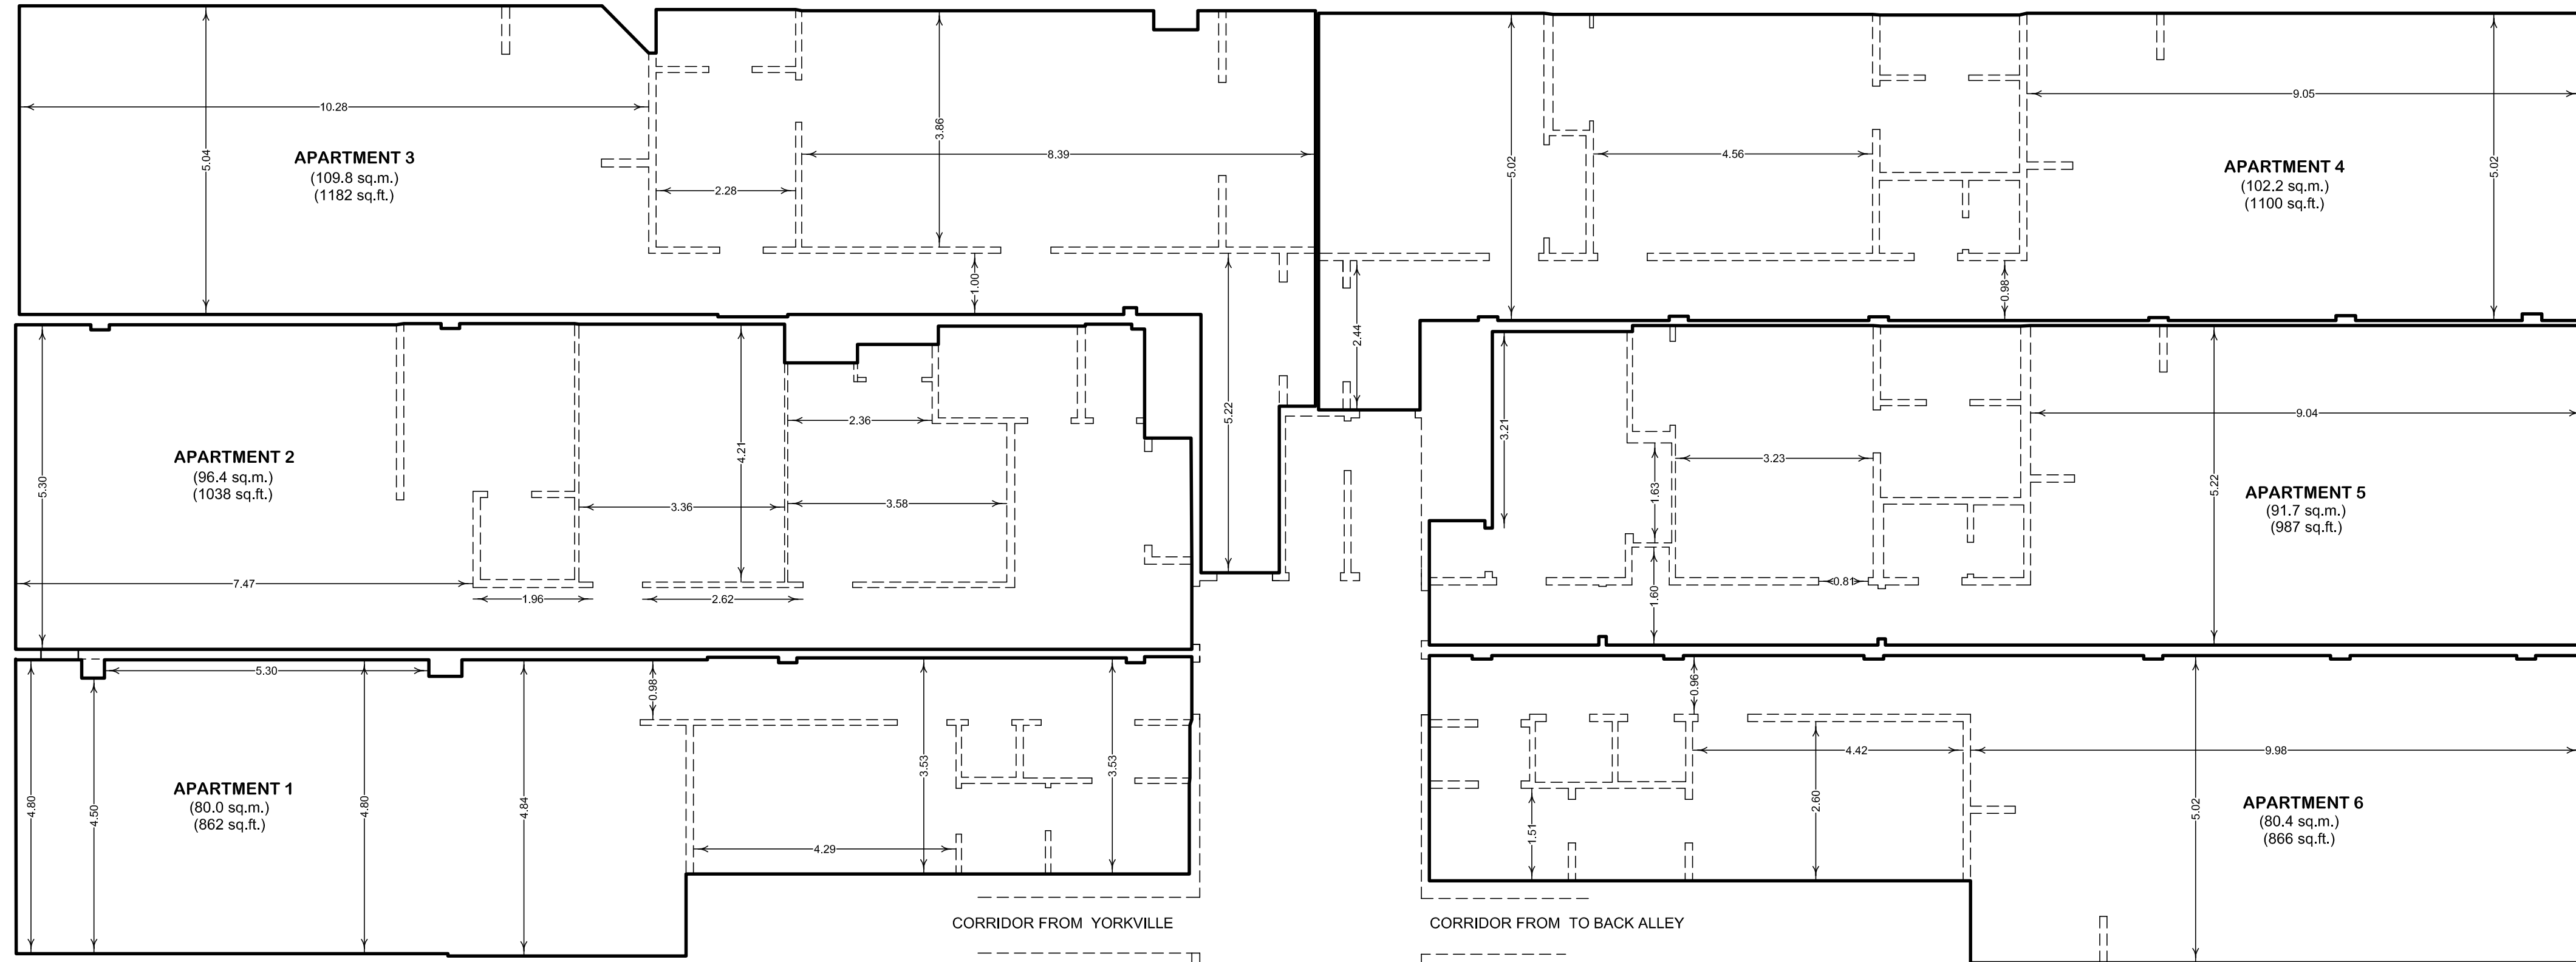

	<b>WSP Geomatics Ontario Limited</b> Ontario Land Surveyors	Drawing Number : <b>17M-01494-000</b>
	610 Chartwell Road, Suite 300, Oakville, Ontario Canada, L6J 4A5 t: 905-823-8500 f: 905-823-8503 Website : www.wspgroup.ca	
P.Chief : A.K.	Dwg. By : C.E.W.	Chk'd by : G.M.
Job Number : 17M-01494-00-AV1	Tab Name: APT 1-6	
Dwg File Name:		21 YORKVILLE.DWG

K:\Jobs\1717M-01494\_Yorkville.dwg\21 Yorkville.dwg